Click Here for Field Notes
Click Here for State Bdry Notes

(23)
accession no. 2530
39
29-60

TOWNSHIP No. 29 NORTH. RANGE No. 60 WEST of the 6TH Principal MERIDIAN.

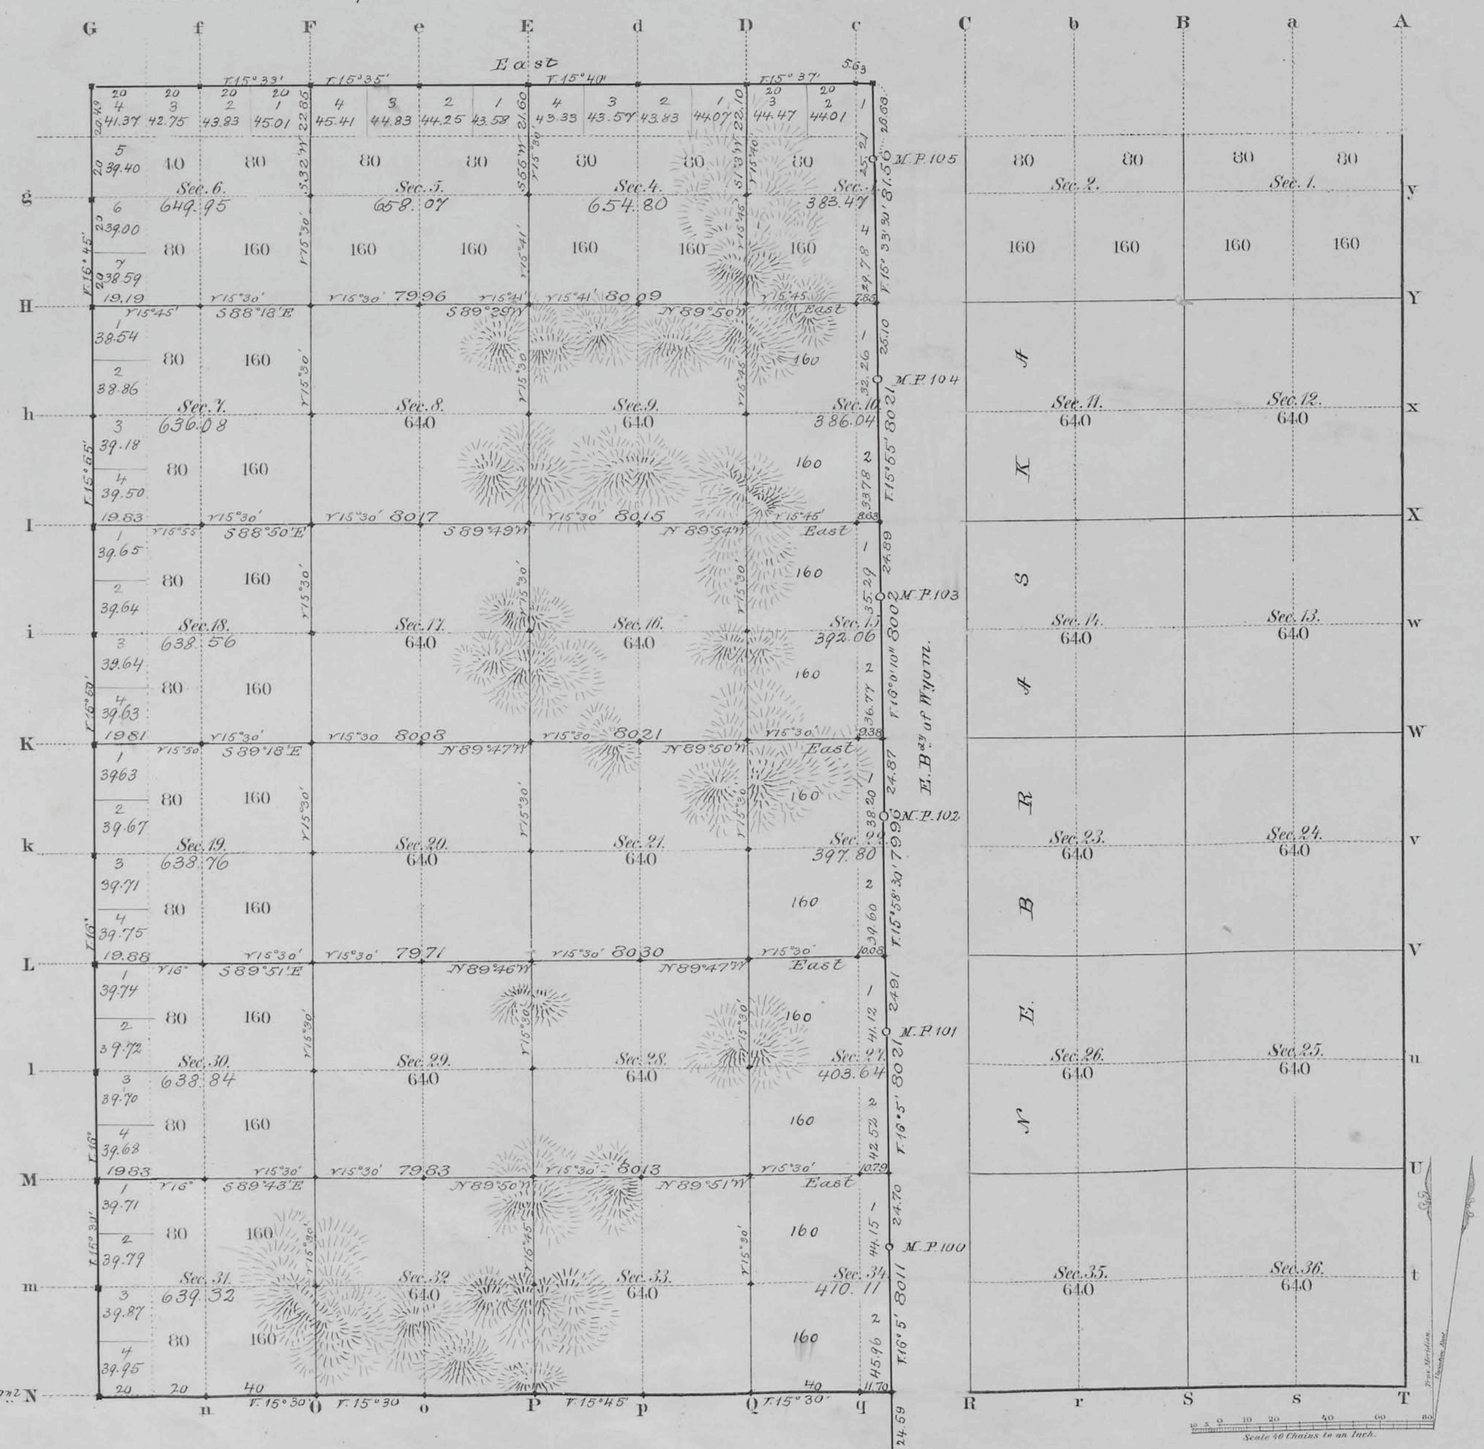

Total number of Acres. 13927,50

Surveys Designated	By Whom Surveyed	Date of Contract	Amount of Surveys Mls	Chs	Lks	When Surveyed	Magnetic Declination
W. & N. Township lines	W. B. Yerby	Aug. 15, 1878	9	46	12	Oct. 15, 1878	15° 40' East
Subdivisions	J. E. Porter	May 24, 1882	36	12	45	July 26-29, 1882	15° 30' "
Connections	" " "	" " "	1	44	47	" " "	
7" Stand. P. N.	W. B. Yerby	Apr. 23, 1878	3	51	70	June 6, 1878	
E. Bdy of Wyo.	O. N. Chaffee	———	6	02	07	Sptb. 2, 1869	

The above Map of Township No. 29 North Range No. 60 West of the Sixth Principal Meridian Wyoming Territory is strictly conformable to the field notes of the survey thereof on file in this Office, which have been examined and approved

Surveyor General's Office,
Cheyenne Wyoming
November 1st 1883

Edw. C. David
Sur. Genl.

A. Gast & Co., St. Louis, Mo.

(10)

Indexed

32

Click Here for Field Notes

Retracement Notes, All or Part

617

EXTERIOR LINES.

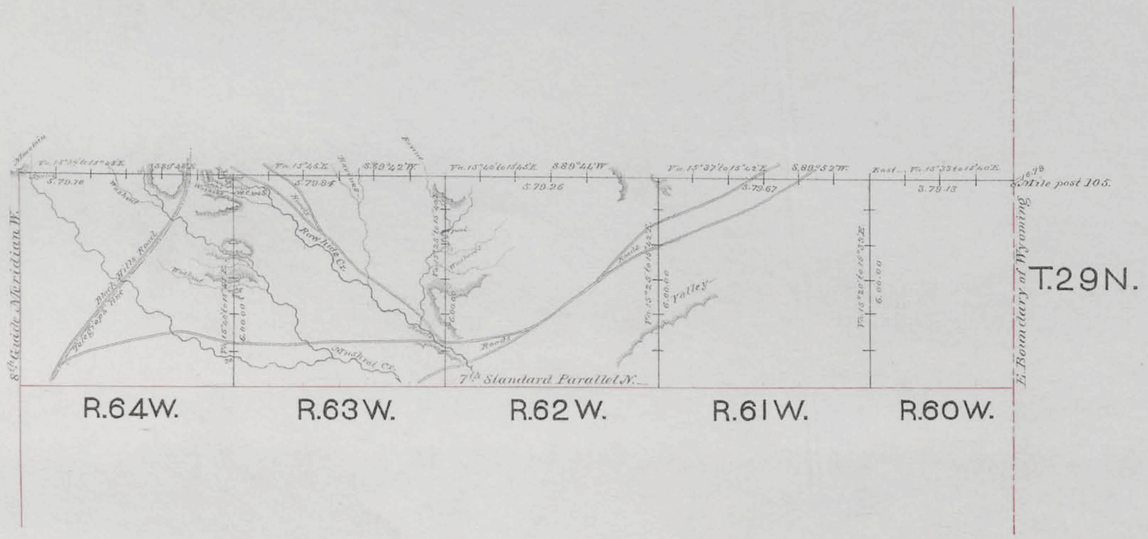

Surveys designated	By whom surveyd	Date of contract.	Amount of surveys. Mls. Chs. Lks.	When surveyed.
Township lines.	Wm. B. Yerby	Aug. 15. 1878.	31 . 77 . 60	Oct. 1878.
Connections.	" " "	" " "	16 . 78	" "

I hereby certify that the above diagram of the exterior lines of Townships 29 North, Ranges 60 to 64 West of the 6th Principal Meridian, Wyoming Territory, is strictly conformable to the field notes of the survey thereof, on file in this office, which have been examined and approved.

Surveyor General's Office,
Cheyenne, Wyo. Feb. 15, 1879.

Edw. C. David
Surveyor General.

513

Click Here for Field Notes

CORRECTIONS.

in Townships 30 to 40 North inclusive, Range 60 W., 6th P.M.

Wyoming Territory.

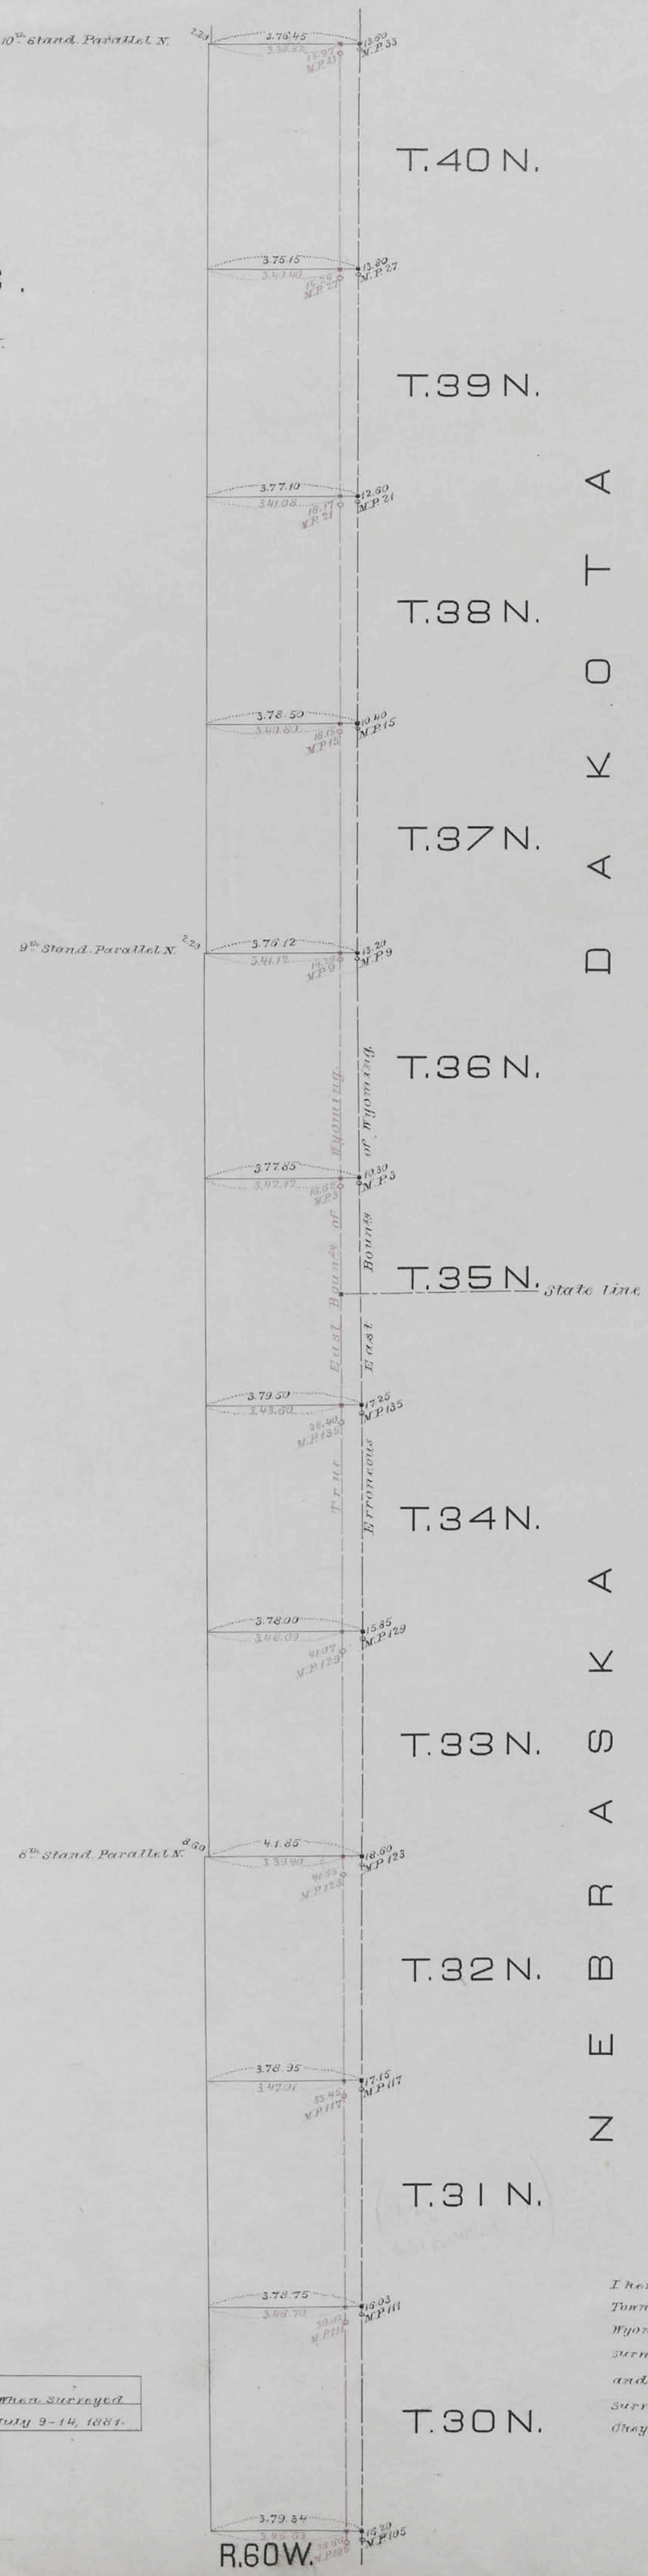

Scale, 3 miles to an inch.

Surveys Designated	By whom surveyed	Date of Contract	Amount of Surveys			When Surveyed
			mls.	chs.	lks.	
Corrections in K.50W. in red ink	Chas. W. Brown	May 9th 1881	3	74	52	July 9-14, 1881.

I hereby certify that the above diagram of the Corrections in Townships 30 to 40 N. inclusive, Range 60 W. of the 6th Principal Merid.n Wyoming Territory, is strictly conformable to the field notes of the survey thereof on file in this Office, which have been examined, and approved.

Surveyor General's Office,
Cheyenne, Wyom. April 26, 1882.

Edw. C. David
Surveyor General.

accession no. 1066

754

20

(9)

Indexed

Click Here for Field Notes

Retracement Rs. 60 - 61 W.

74

568

SEVENTH STANDARD PARALLEL NORTH,

From the 8th Guide Meridian W. between Townships 28 & 29 N. to the E. Boundary of Wyoming.

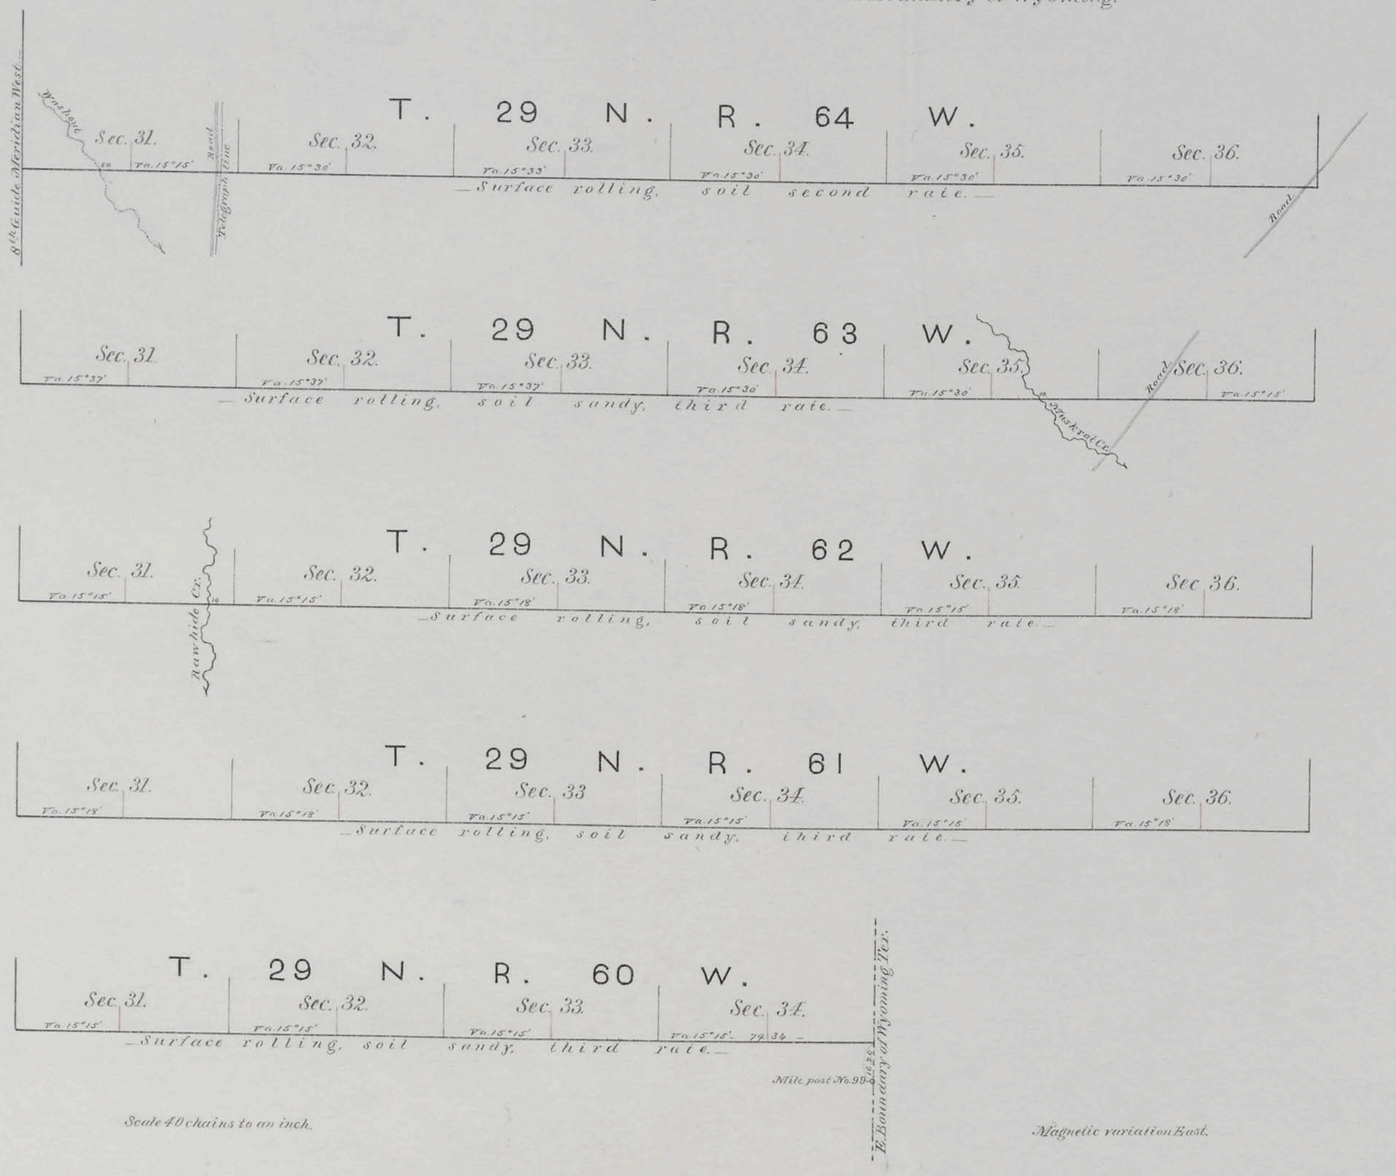

Scale 40 chains to an inch.

Magnetic variation East.

Surveys designated.	By whom surveyed.	Date of contract.	Amount of surveys	When surveyed.
			Mls. Chs. Lks.	
7th Stand.d Par.l N.	William B. Yerby.	April 23rd 1878.	27 . 79 . 34	June, 1878.
Connections	" " "	" " "	16 . 20	" "

I hereby certify that the above diagram of the 7th Standard Parallel N. from the 8th Guide Meridian W. to the E. Boundary of Wyoming Territory, is strictly conformable to the original field notes of the survey thereof, on file in this office, which have been examined and approved.

Surveyor General's Office,
Cheyenne, Wyo. Sept. 23, 1878.

Edw. C. David
Surveyor General.

480

5977

Click Here for Field Notes

MAP

of the

Resurvey, Remarking and Re-establishing of the Boundary Line

between

WYOMING and NEBRASKA

and the

Re-establishment of the Closing Corners

of Public Land Surveys

Surveyed by Edward F. Stahle, U.S. Surveyor

RECEIVED S. G. O.
MAR 12 1909
CHEYENNE, WYO.

Sheet No 2

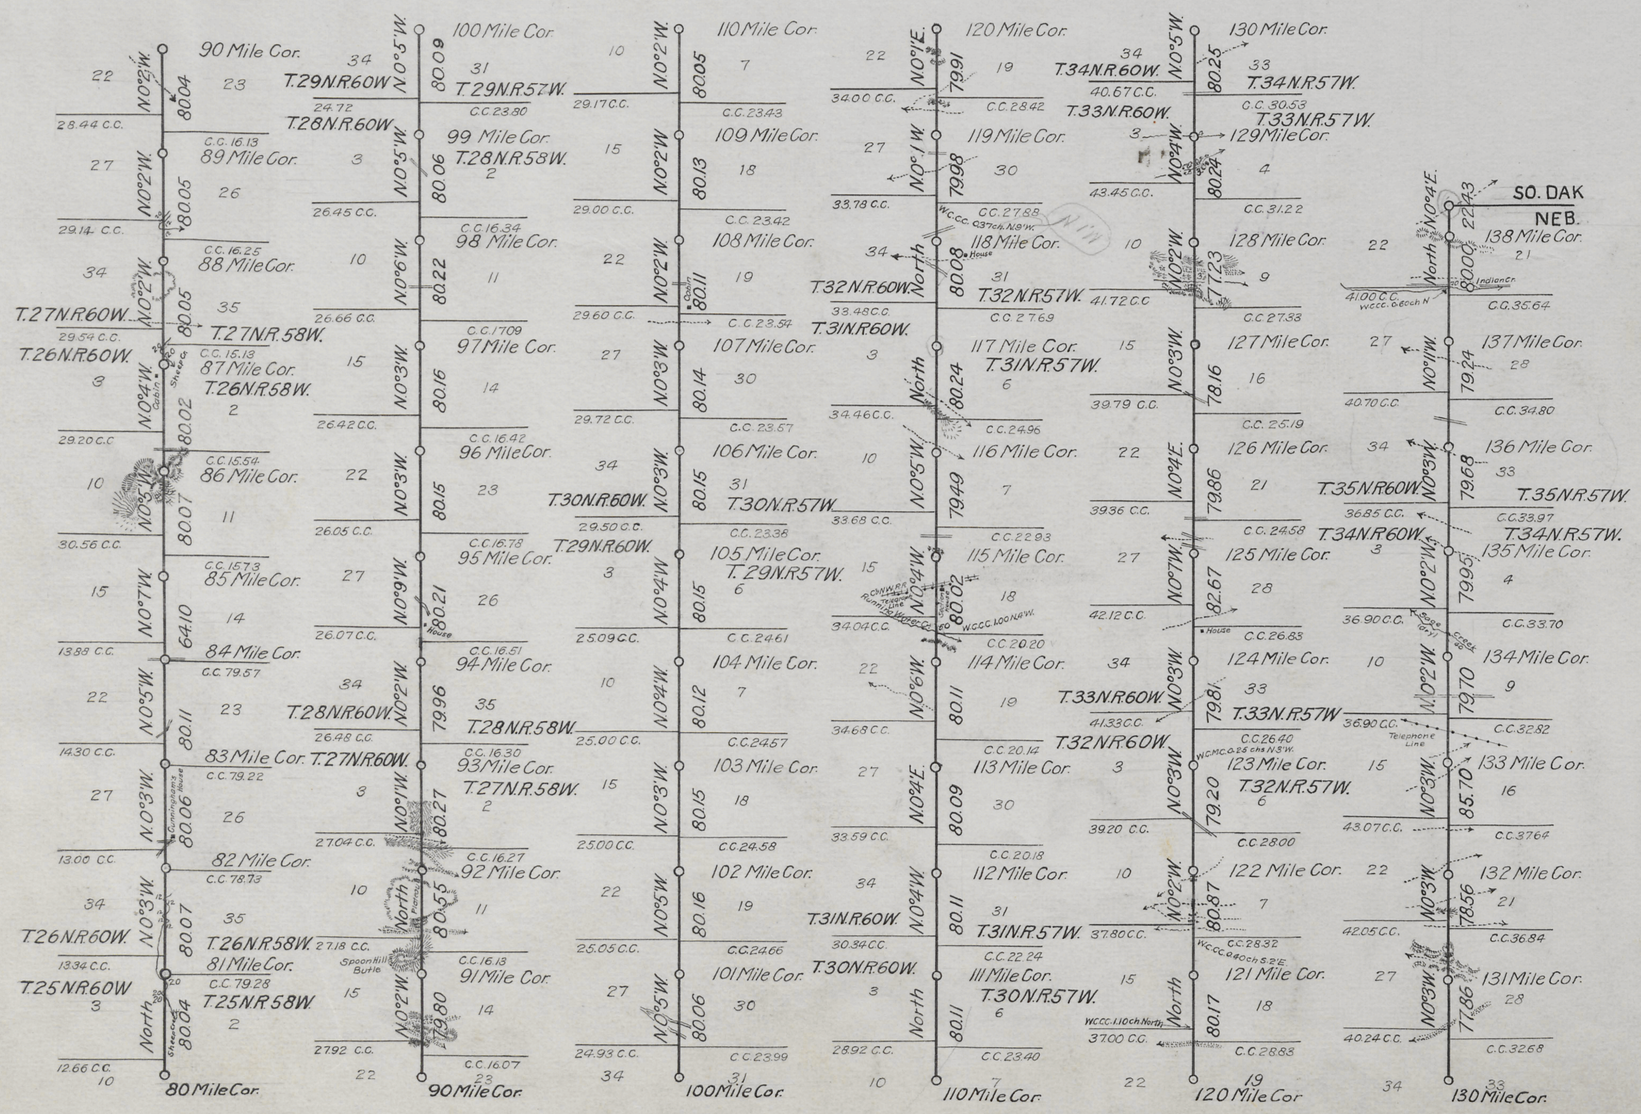

Department of the Interior,
General Land Office,
February 13, 1909.

This Map of the Resurvey, Remarking and Re-establishing of the Boundary Line between Wyoming and Nebraska, and the Re-establishment of the Closing Corners on said Boundary Line (on two sheets), surveyed by Edward F. Stahle, U.S. Surveyor, under his Contract dated June 27, 1907, being conformable to the field notes of the survey thereof on file in this office, is hereby approved.

Fred Dennett

Commissioner.