Click Here for Field Notes

Click Here for State Bdry Notes

(14) 1193 34

33-60

TOWNSHIP No. 33 NORTH, RANGE No. 60 WEST of the 6th Principal MERIDIAN.

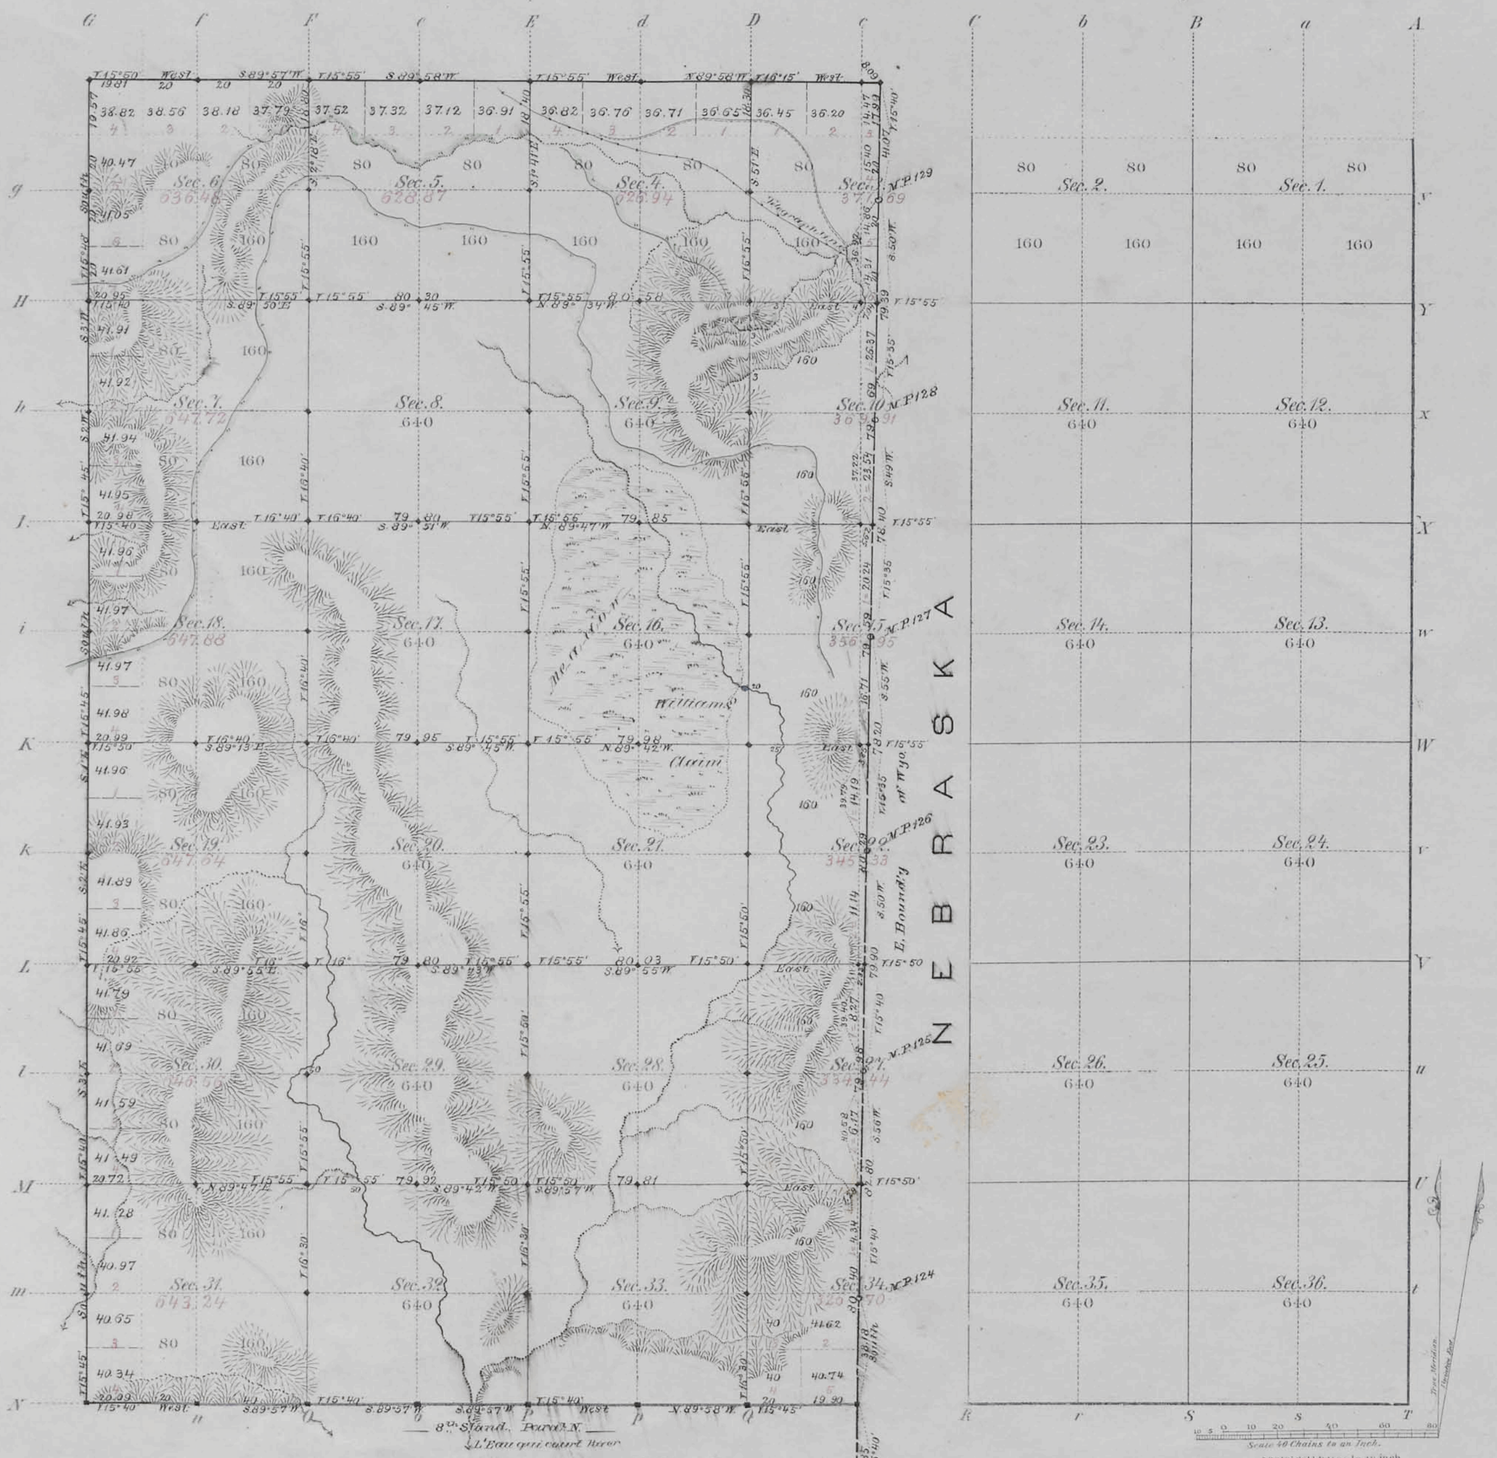

Total number of Acres. 13,630.35

Surveys Designated	By Whom Surveyed	Date of Contract	Amount of Surveys Mls	Chs	Lks	When Surveyed	Magnetic Declination
6th P. N. Township lines	Charles W. Brown	July 23, 1880	9	47	47	Aug. 26 & 27, 1880	15° 52' East
Subdivisions	Camp & Fairfield	May 9, 1881	35	60	20	July 14-16, 1881	15° 55' " "
Connections	" " "	" " "	2	33	91	" " "	
8th Stand. Par. N.	Charles W. Brown	May 22, 1879	3	39	99	July 3, 1879	
E. Bound. of Wyo	O. N. Chaffee	—	5	77	94	Sept. 3, 4, & 6, 1869	

The above Map of Township No. 33 North of Range No. 60 West of the Sixth Principal Meridian Wyoming Territory is strictly conformable to the field notes of the survey thereof on file in this Office, which have been examined and approved

Surveyor General's Office,
Cheyenne Wyoming
August 11th 1882

Edw. C. David
Surv. Genl.

870

A. Gast & Co., St. Louis, Mo.

33 - 60

Click Here for Field Notes

CORRECTIONS.

in Townships 30 to 40 North inclusive, Range 60 W., 6th P.M.

Wyoming Territory.

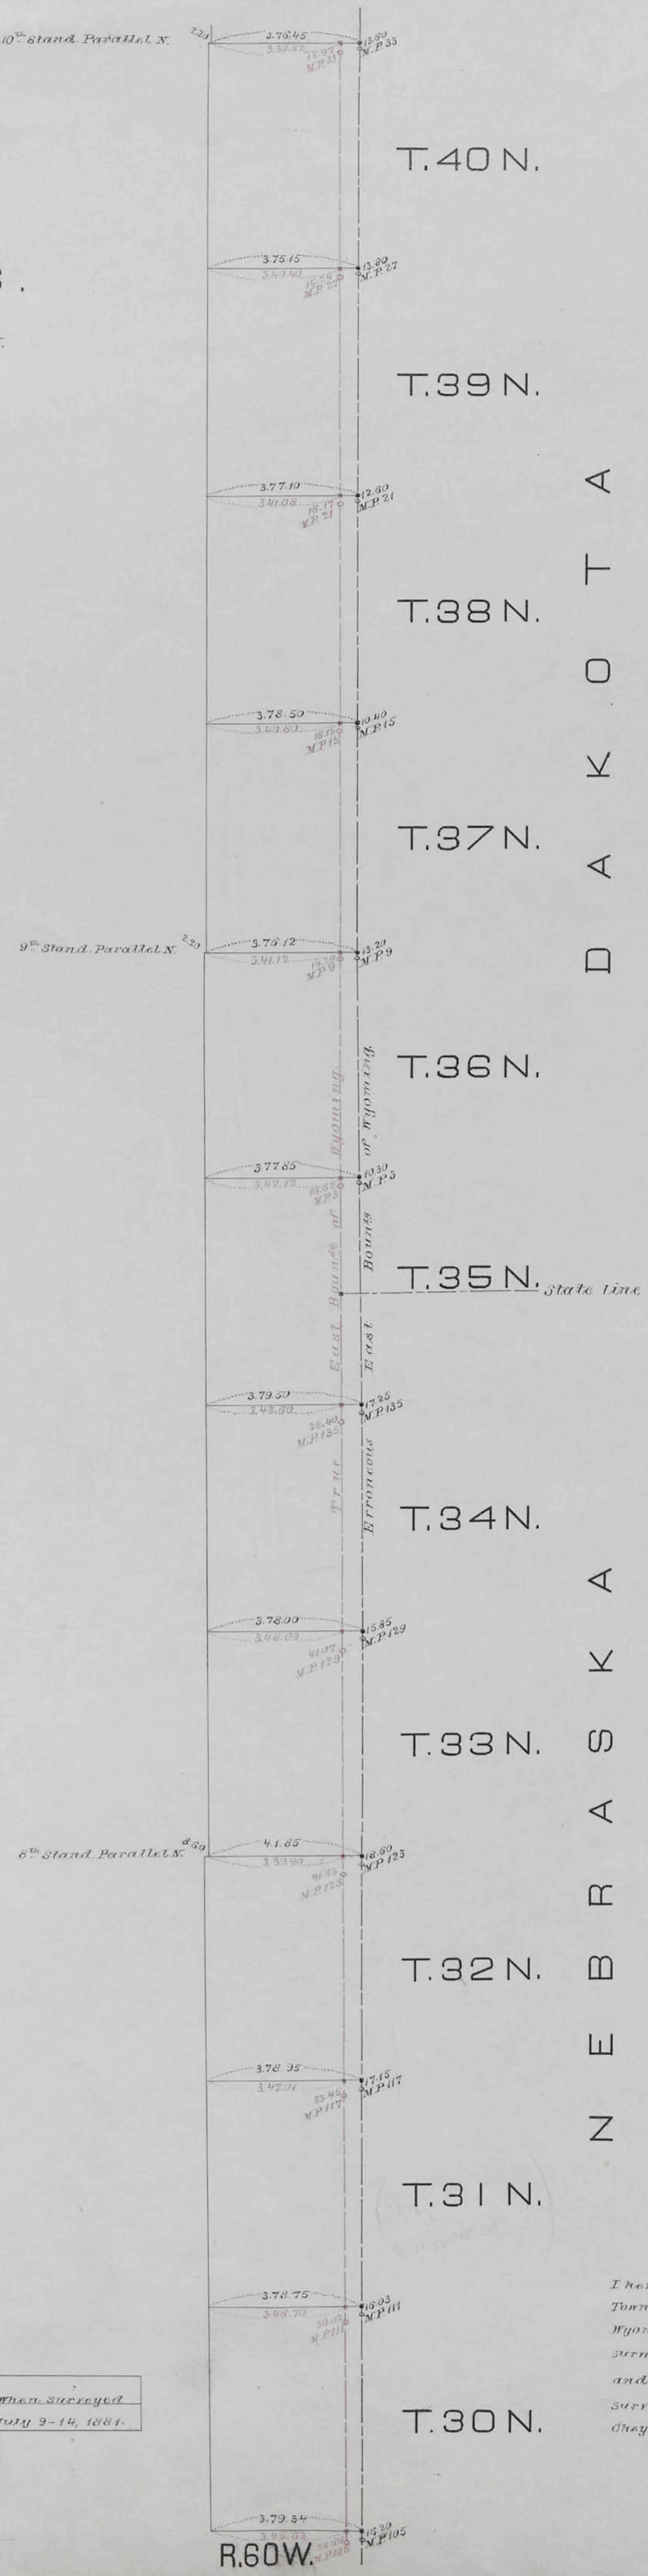

Scale, 3 miles to an inch.

Surveys Designated	By whom surveyed	Date of Contract	Amount of Surveys			When Surveyed
			mls.	chs.	lks.	
Corrections in K.50W. in red ink	Chas. W. Brown	May 9th 1881	3	74	52	July 9-14, 1881.

I hereby certify that the above diagram of the Corrections in Townships 30 to 40 N. inclusive, Range 60 W. of the 6th Principal Merid.n Wyoming Territory, is strictly conformable to the field notes of the survey thereof on file in this Office, which have been examined, and approved.

Surveyor General's Office,
Cheyenne, Wyom. April 26, 1882.

Edw. C. David
Surveyor General.

accession no. 1066

754

20

(10)
Indexed

661

Field Notes Tps. 33-36 N.

Retracement Notes, All or Part

69

EXTERIOR LINES.

Surveys designated	By whom surveyed	Date of contract	Amount of surveys Mls.	Chs.	Lks.	When surveyed
Township lines	Charles W. Brown	July 23, 1880	360 "	16 "	12 "	October 1880
Corrections	" " "	" " "	1 "	19 "	51 "	" " "
Corrections in R.60W. (in red ink)	Charles W. Brown	May 9, 1881	2	16	21	July 10-14, 1881

I hereby certify that the above diagram of the exterior lines of Townships 33 to 40 North, Ranges 60 to 64 West, of the 6th Prin.l Mer.n in Wyo.Ter. is strictly conformable to the field notes of the survey, thereof on file in this Office, which have been examined and approved.

Surveyor General's Office
Cheyenne, Wyo. Dec. 16th 1880

Edw. C. David
Surveyor General.

550

(10)

Click Here for Field Notes

633

EIGHTH STANDARD PARALLEL NORTH,

From the 8th Guide Meridian W. between Townships 32 & 33 N. to the E. Boundary of Wyoming.

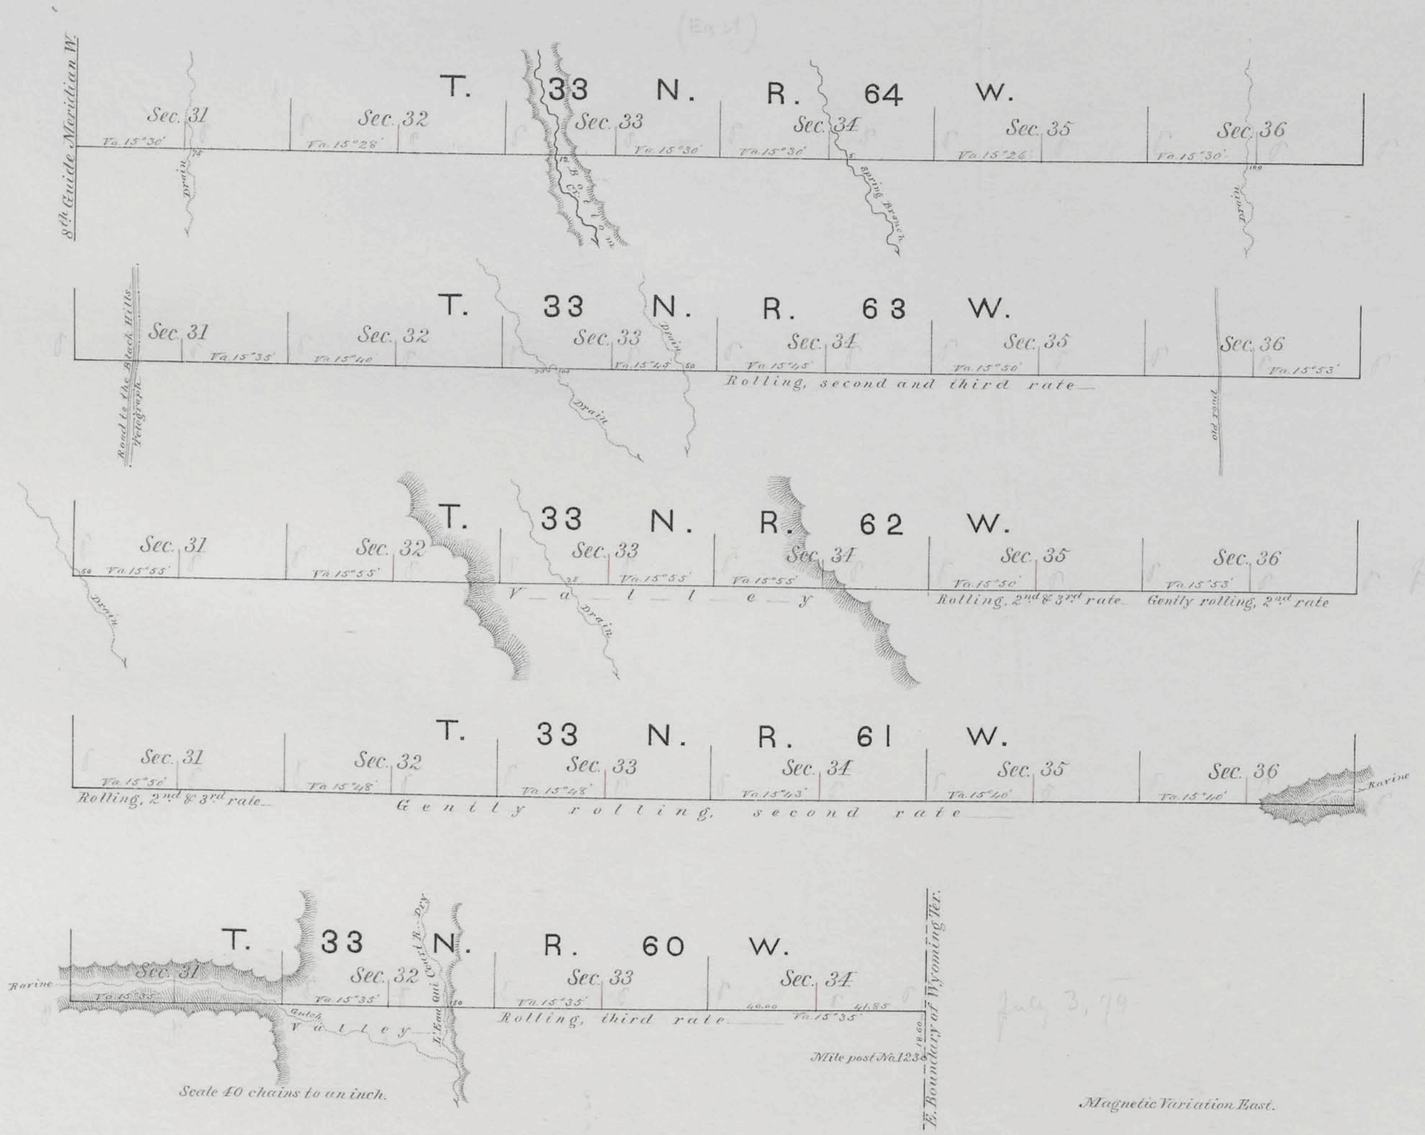

Scale 40 chains to an inch.

Magnetic Variation East.

Surveys designated.	By whom surveyed.	Date of contract.	Amount of surveys.	When surveyed.
8th Standard Parallel N.	Charles W. Brown	May 22nd 1879	Mls. 28 Chs. 1 Lks. 85	July, 1879.
Connections.	" " "	" " "	18 . 60	" "

I hereby certify that the above diagram of the 8th Standard Parallel N. from the 8th Guide Meridian W. to the E. Boundary of Wyoming Territory, is strictly conformable to the original field notes of the survey thereof, on file in this office, which have been examined and approved.

Surveyor General's Office,
Cheyenne, Wyo. Oct. 29, 1879.

Edw. C. David
Surveyor General

5977

Click Here for Field Notes

MAP

of the

Resurvey, Remarking and Re-establishing of the Boundary Line

between

WYOMING and NEBRASKA

and the

Re-establishment of the Closing Corners

of Public Land Surveys

Surveyed by Edward F. Stahle, U.S. Surveyor

RECEIVED S. G. O.
MAR 12 1909
CHEYENNE, WYO.

Sheet No 2

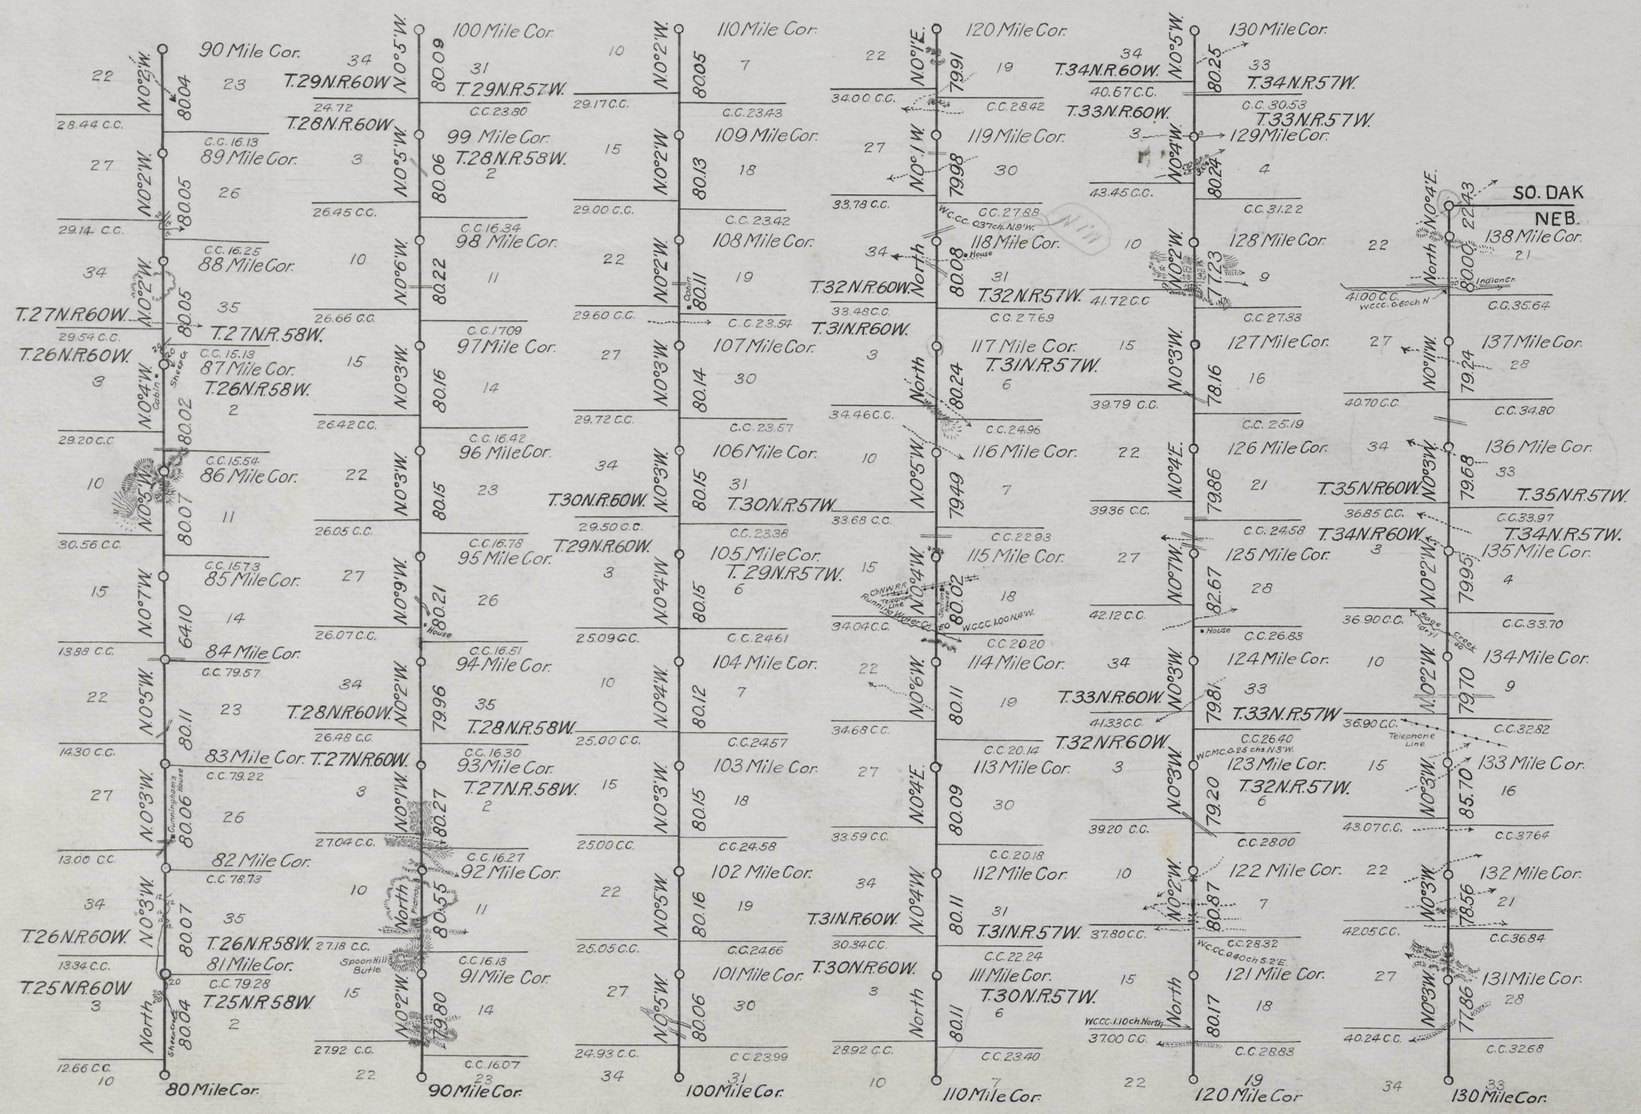

Department of the Interior,
General Land Office,
February 13, 1909.

This Map of the Resurvey, Remarking and Re-establishing of the Boundary Line between Wyoming and Nebraska, and the Re-establishment of the Closing Corners on said Boundary Line (on two sheets), surveyed by Edward F. Stahle, U.S. Surveyor, under his Contract dated June 27, 1907, being conformable to the field notes of the survey thereof on file in this office, is hereby approved.

Fred Dennett

Commissioner.

27